


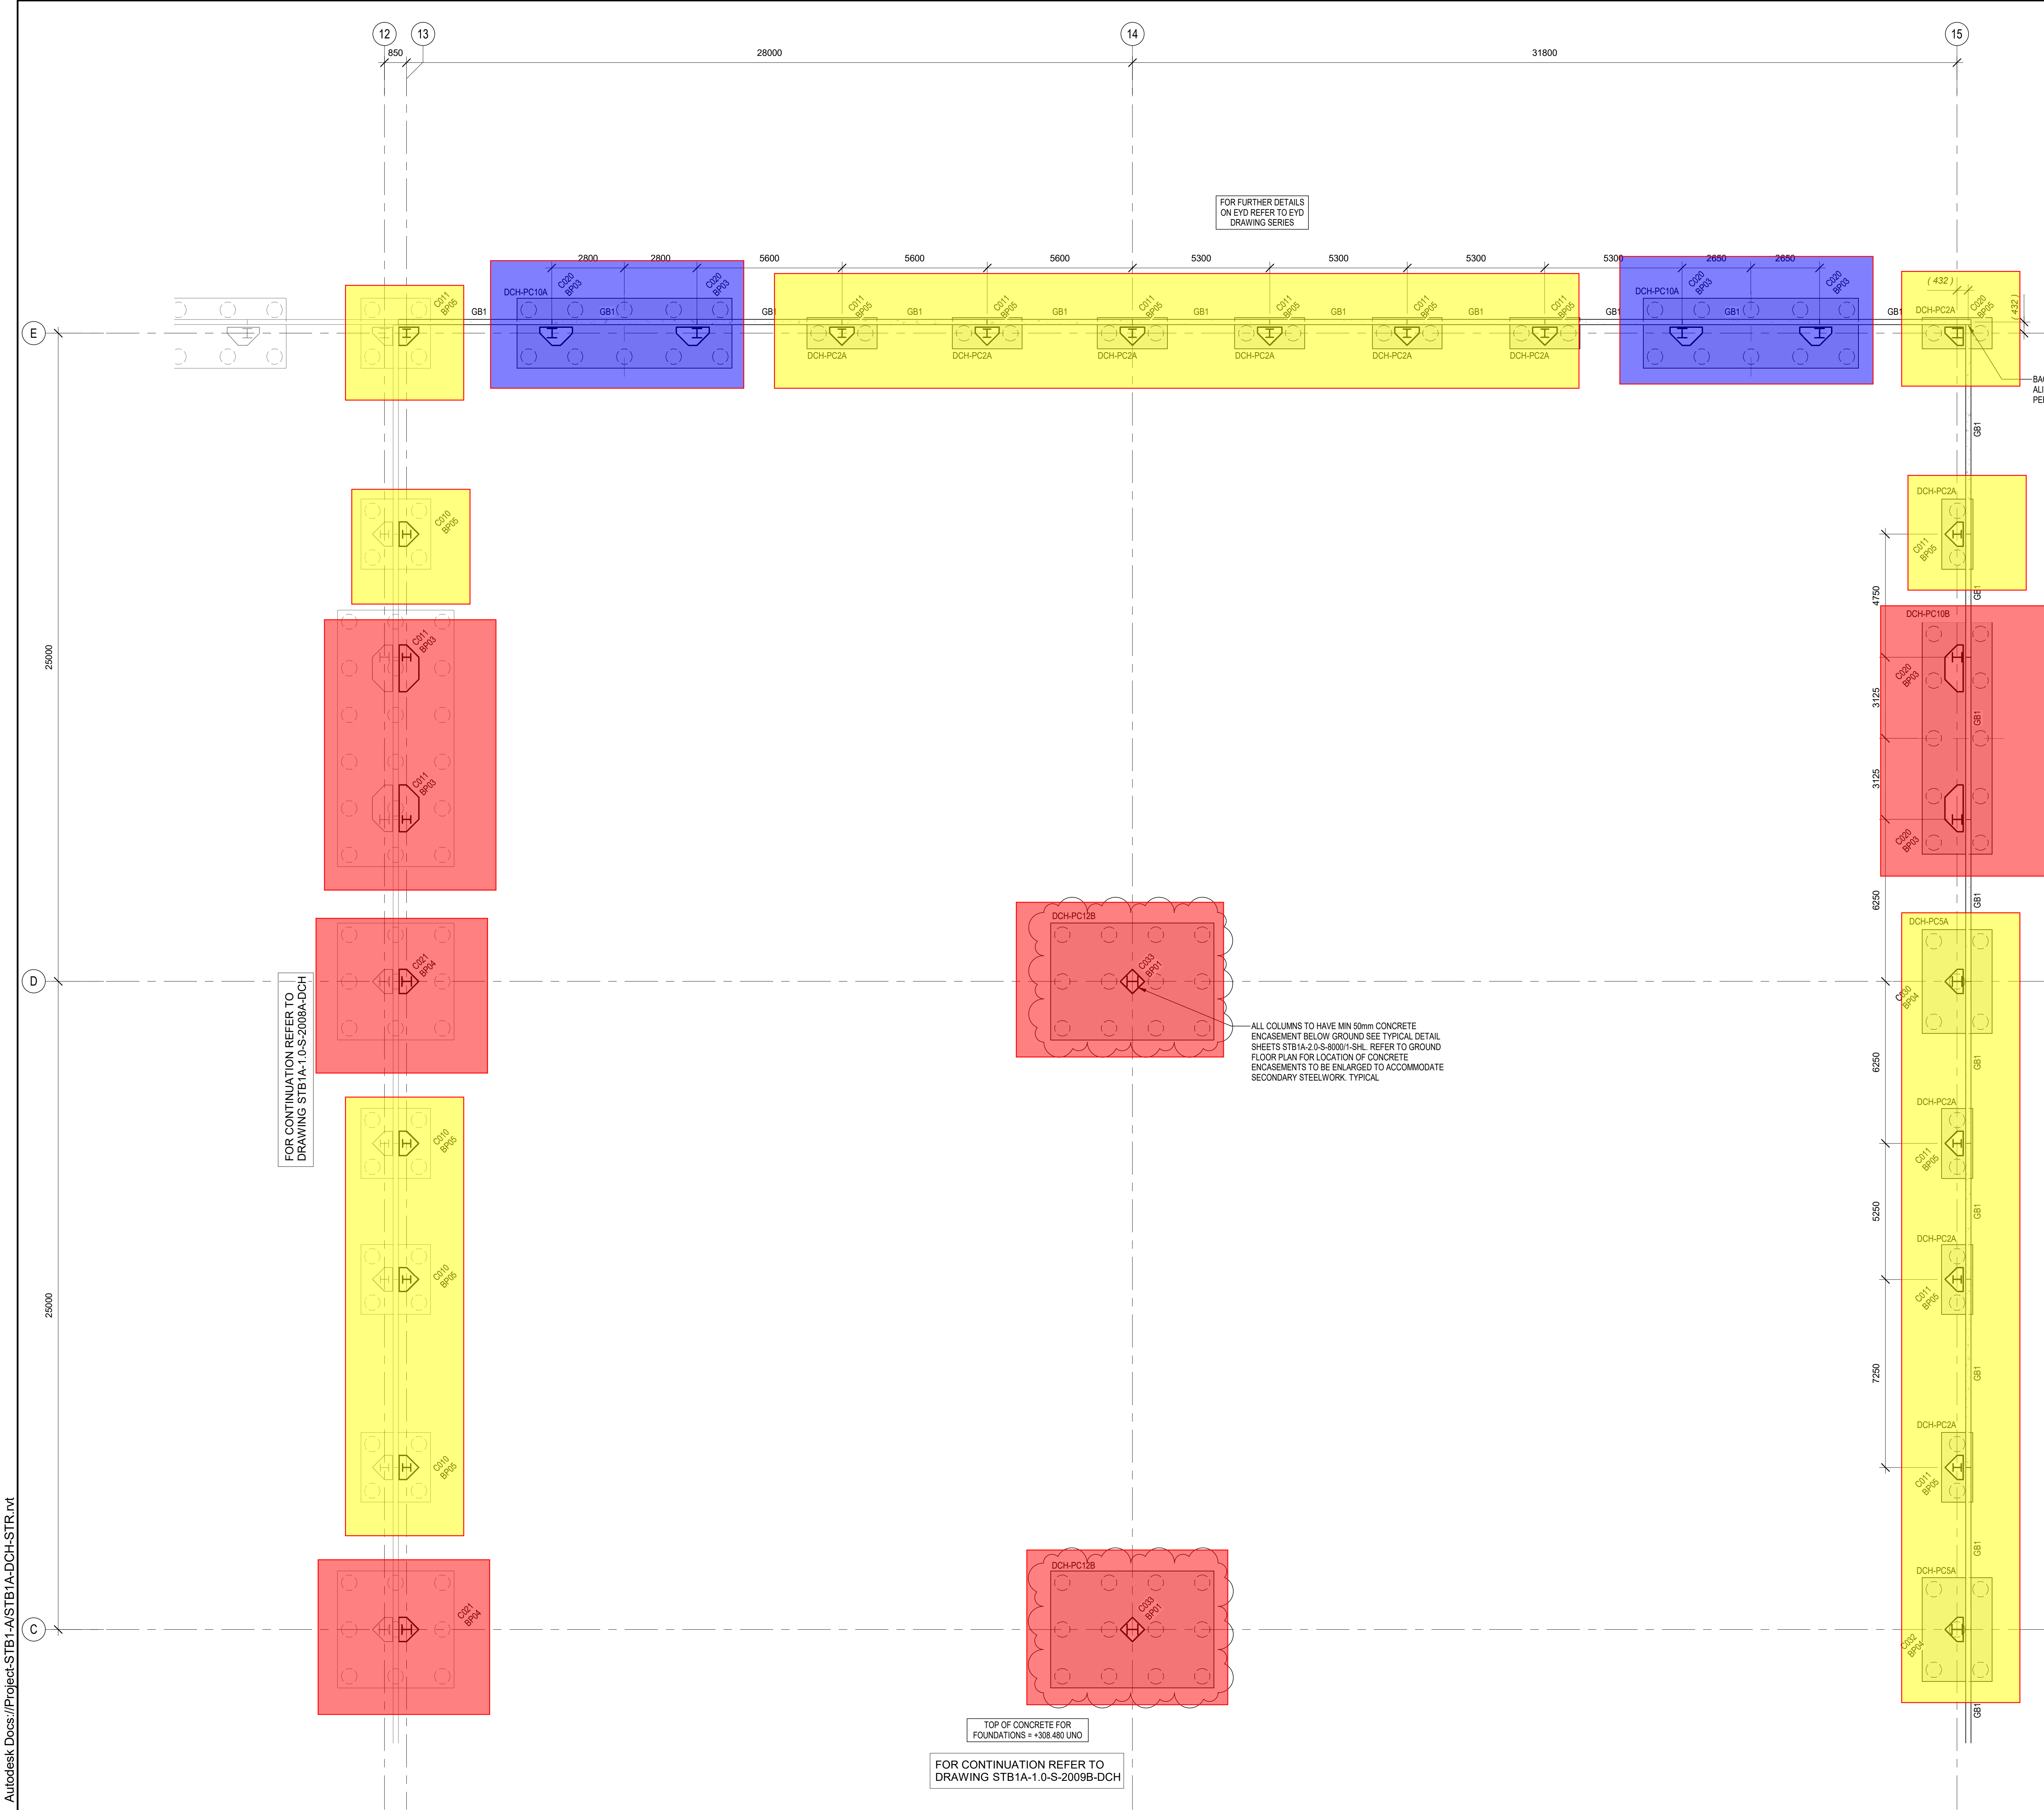

Dig:307.385
Blind: 307.485
Cut: 307.560
Dig: 306.975
Blind: 307.075
Cut: 307.150
Dig: 306.785
Blind: 306.885
Cut: 306.960

- NOTES:
- DO NOT SCALE FROM THIS DRAWING
 - ALL DIMENSIONS ARE IN MILLIMETRES UNO.
 - ALL LEVELS ARE IN METRES UNO
 - THIS DRAWING TO BE READ IN CONJUNCTION WITH ALL RELEVANT ARCHITECTS AND ENGINEERS DRAWINGS AND SPECIFICATIONS
 - FOR GENERAL NOTES REFER TO DRAWING STB1A-1.0-S-0010-SHL
 - FOR SUBSTRUCTURE SECTIONS AND DETAILS REFER TO DRAWING SERIES STB1A-2.0-S-8000-SHL
 - ALL FOUNDATION PADS ARE CENTERED ON COLUMNS UNLESS NOTED OTHERWISE
 - GROUND LEVEL SLAB OMITTED FOR CLARITY
 - TOP OF CONCRETE ENCASMENT AT COLUMNS SURROUNDED BY SLAB IN ENCLOSED SPACES TO MATCH TOP OF SURROUNDING STRUCTURAL SLAB AT FINAL CONDITION. SEE TYPICAL SEQUENCE OF STEEL COLUMN ENCASMENT DETAIL ON STB1A-2.0-S-8000-SHL
 - ALL CONCRETE TO BE GRADE C30/37
 - ALL REINFORCEMENT TO BE GRADE S50B MINIMUM
 - GROUND FLOORS SLAB DESIGN IS BASED UPON A MINIMUM MODULUS OF SUB GRADE REACTION ACHIEVING A K_{0.05}9N/mm² (APPROXIMATELY 30% CBR)

DCH PILECAP FOUNDATION SCHEDULE

*DENOTES TO REFER TO PLAN			
TYPE MARK	LENGTH (mm)	WIDTH (mm)	DEPTH (mm)
DCH-PC2A	2700	1200	1000
DCH-PC4A	2700	2700	1000
DCH-PC5A	4000	2700	1000
DCH-PC6A	4500	2700	1000
DCH-PC8A	4500	4500	1600
DCH-PC9A	4500	4500	1600
DCH-PC10A	8300	2700	1400
DCH-PC10B	8950	2700	1400
DCH-PC12A	SEE DETAIL ON 8002		1000
DCH-PC12B	6300	4500	1600
DCH-PC18A	9900	4500	1600

DCH PLINTH SCHEDULE

Type Mark	LENGTH (mm)	WIDTH (mm)	DEPTH (mm)
DCH-PL01	550.00	550.00	600
DCH-PL02	550.00	550.00	800
DCH-PL03	2500.00	550.00	800

DCH FOUNDATION RC INTENT

TYPE MARK	TOP	BOTTOM	SIDE
DCH-PC2A	#20@150	#20@150	#16@200
DCH-PC4A	#20@150	#20@150	#16@200
DCH-PC5A	#20@150	#20@150	#16@200
DCH-PC6A	#20@150	#20@150	#16@200
DCH-PC8A	#26@125	#26@125	#16@200
DCH-PC9A	#26@125	#26@125	#16@200
DCH-PC10A	#26@125	#26@125	#16@200
DCH-PC10B	#26@125	#26@125	#16@200
DCH-PC12A	#20@150	#20@150	#16@200
DCH-PC12B	#26@125	#26@125	#16@200
DCH-PC18A	#26@125	#26@125	#16@200

GROUND BEAM SCHEDULE

REF	TYPE
GB1	200x750 DEEP PRECAST BEAM

PRECAST BEAM RC INTENT = T&B: 2 No. #16 - SIDE: #12@200 - STIRRUP: #12@200

DCH - STRUCTURAL SPS COLUMN

TYPE MARK	TYPE
C010	HD 320 x 97.6
C011	HD 320 x 127
C020	HD 360 x 134
C021	HD 360 x 162
C030	HD 400 x 187
C032	HD 400 x 287
C033	HD 400 x 382


13/06/2025 16:09:24 Autodesk Docs://Project/STB1A-1.0-S-2009A-DCH-STR.rvt

ARCHITECTURE:
ARC:MC
39 Moreland Street
London, EC1V 8BB
United Kingdom
t: +44 (0) 203 411 2571
e: info@arcmc.co.uk

STRUCTURE:
SWECO
Eldon House
2-3 Eldon Street
London, EC2M 7LS
+44 (0) 20 3002 1210
e: www.sweco.co.uk

MEP:
Black & White Engineering
69 Wilson Street
London, EC2A 2BB
United Kingdom
t: +44 207 663 7166
www.bw-engineering.com

STB1A - PUF - IFC FINAL ISSUE
(ISSUE FOR CONTRACT)
2025-06-20

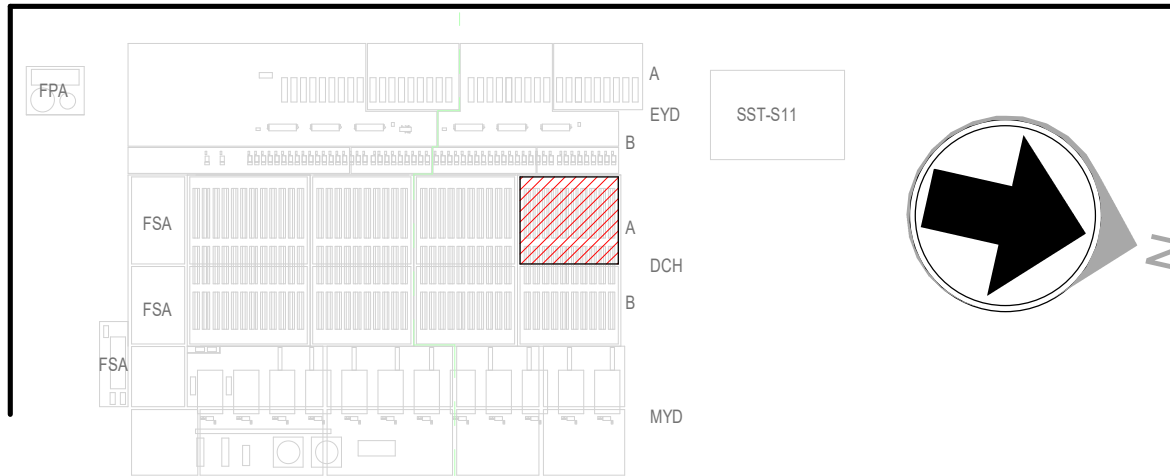


REVISIONS		
NO.	DATE	DESCRIPTION
0.1	06/06/2024	R00 DRAFT ISSUE
0.2	06/06/2024	R00 FINAL ISSUE
0.3	20/12/2024	IFC DRAFT ISSUE
0.4	21/02/2025	IFC DRAFT ISSUE
1.0	12/03/2025	IFC FINAL ISSUE
1.1	30/05/2025	POST IFC DRAFT ISSUE
2.0	20/06/2025	POST IFC FINAL ISSUE

Drawn By:
DS
Approved By:
GC
Design Team:
B&W

GDC - DCH-STR
BUCKINGHAM
Project Number: P20251

Foundation General Arrangement Shell 2 Sheet
3 of 4
Discipline:
STRUCTURAL
Scale: 1 : 100 Sheet Size: A0

Sheet Number:
STB1A-1.0-S-2009A-DCH
Current Rev: 2.0
Phase: IFC
Model Name: STB1A-DCH-STR.rvt
Native File Format: Revit v. 2025.4

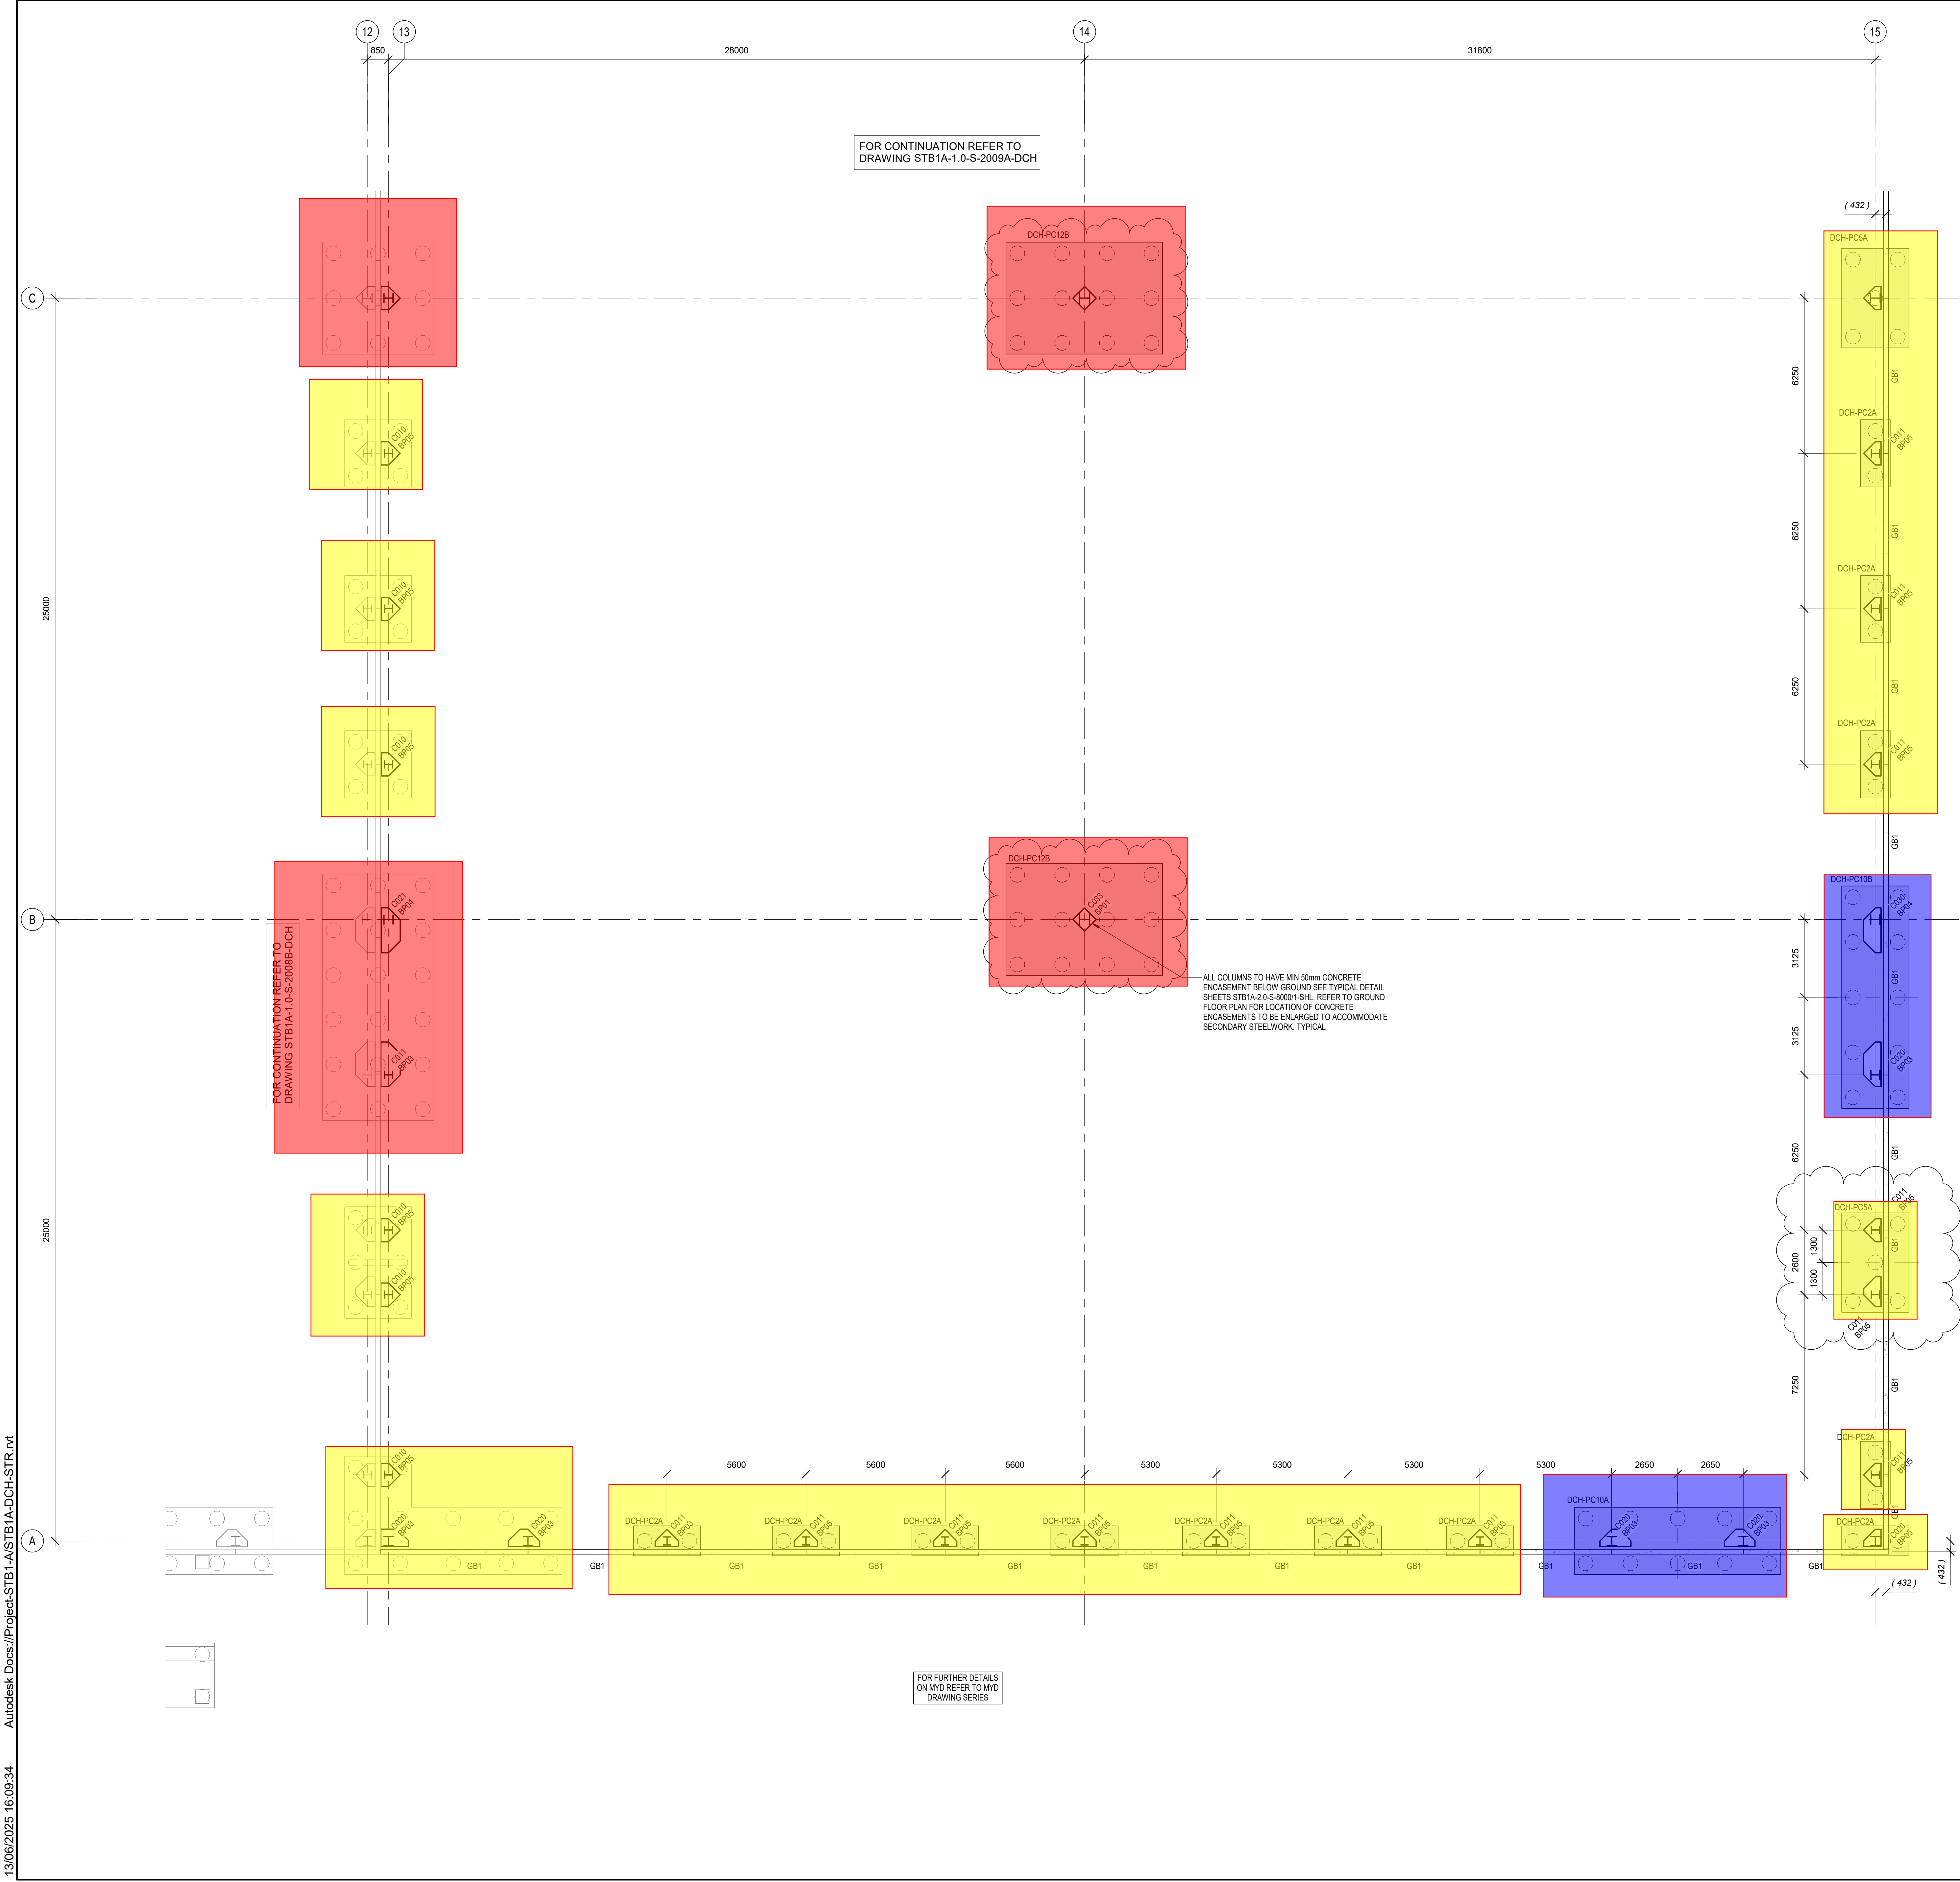

Dig:307.385
Blind: 307.485
Cut: 307.560
Dig: 306.975
Blind: 307.075
Cut: 307.150
Dig: 306.785
Blind: 306.885
Cut: 306.960

TOP OF CONCRETE FOR FOUNDATIONS = +308.480 UNO

- NOTES:
- DO NOT SCALE FROM THIS DRAWING
 - ALL DIMENSIONS ARE IN MILLIMETRES UNO.
 - ALL LEVELS ARE IN METRES UNO
 - THIS DRAWING TO BE READ IN CONJUNCTION WITH ALL RELEVANT ARCHITECTS AND ENGINEERS DRAWINGS AND SPECIFICATIONS
 - FOR GENERAL NOTES REFER TO DRAWING STB1A-1.0-S-0010-SHL
 - FOR SUBSTRUCTURE SECTIONS AND DETAILS REFER TO DRAWING SERIES STB1A-2.0-S-8000-SHL
 - ALL FOUNDATION PADS ARE CENTERED ON COLUMNS UNLESS NOTED OTHERWISE
 - GROUND LEVEL SLAB OMITTED FOR CLARITY
 - TOP OF CONCRETE ENCASMENT AT COLUMNS SURROUNDED BY SLAB IN ENCLOSED SPACES TO MATCH TOP OF SURROUNDING STRUCTURAL SLAB AT FINAL CONDITION. SEE TYPICAL SEQUENCE OF STEEL COLUMN ENCASMENT DETAIL ON STB1A-2.0-S-8000-SHL
 - ALL CONCRETE TO BE GRADE C30/37
 - ALL REINFORCEMENT TO BE GRADE S50B MINIMUM
 - GROUND FLOORS SLABS DESIGN IS BASED UPON A MINIMUM MODULUS OF SUB GRADE REACTION ACHIEVING A K=0.09N/mm² (APPROXIMATELY 30% CBR)

DCH PILECAP FOUNDATION SCHEDULE

*DENOTES TO REFER TO PLAN			
TYPE MARK	LENGTH (mm)	WIDTH (mm)	DEPTH (mm)
DCH-PC2A	2700	1200	1000
DCH-PC4A	2700	2700	1000
DCH-PC5A	4000	2700	1000
DCH-PC6A	4500	2700	1000
DCH-PC8A	4500	4500	1600
DCH-PC9A	4500	4500	1600
DCH-PC10A	8300	2700	1400
DCH-PC10B	8950	2700	1400
DCH-PC12A	SEE DETAIL ON 8002		1000
DCH-PC12B	6300	4500	1600
DCH-PC18A	9900	4500	1600

DCH PLINTH SCHEDULE

Type Mark	LENGTH (mm)	WIDTH (mm)	DEPTH (mm)
DCH-PL01	550.00	550.00	600
DCH-PL02	550.00	550.00	800
DCH-PL03	2500.00	550.00	800

DCH FOUNDATION RC INTENT

TYPE MARK	TOP	BOTTOM	SIDE
DCH-PC2A	ø20@150	ø20@150	ø16@200
DCH-PC4A	ø20@150	ø20@150	ø16@200
DCH-PC5A	ø20@150	ø20@150	ø16@200
DCH-PC6A	ø20@150	ø20@150	ø16@200
DCH-PC8A	ø26@125	ø26@125	ø16@200
DCH-PC9A	ø26@125	ø26@125	ø16@200
DCH-PC10A	ø26@125	ø26@125	ø16@200
DCH-PC10B	ø26@125	ø26@125	ø16@200
DCH-PC12A	ø20@150	ø20@150	ø16@200
DCH-PC12B	ø26@125	ø26@125	ø16@200
DCH-PC18A	ø26@125	ø26@125	ø16@200

GROUND BEAM SCHEDULE

REF	TYPE
GB1	200x750 DEEP PRECAST BEAM
PRECAST BEAM RC INTENT = T&B: 2 No. ø16 - SIDE: ø12@200 - STIRRUP: ø12@200	

DCH - STRUCTURAL SPS COLUMN

TYPE MARK	TYPE
C010	HD 320 x 97.6
C011	HD 320 x 127
C020	HD 360 x 134
C021	HD 360 x 162
C030	HD 400 x 187
C032	HD 400 x 287
C033	HD 400 x 382



13/06/2025 16:09:34 Autodesk Docs://Project-STB1A-ASTB1A-DCH-STR.rvt

ARCHITECTURE:
ARC:MC
39 Moreland Street
London, EC1V 8BB
United Kingdom
t: +44 (0) 203 411 2571
e: info@arcmc.co.uk

STRUCTURE:
SWECO
Eldon House
2-3 Eldon Street
London, EC2M 7LS
+44 (0) 20 3002 1210
e: www.sweco.co.uk

MEP:
Black & White Engineering
69 Wilson Street
London, EC2A 2BB
United Kingdom
t: +44 207 663 7166
www.bw-engineering.com

STB1A - PUF - IFC FINAL ISSUE
(ISSUE FOR CONTRACT)
2025-06-20

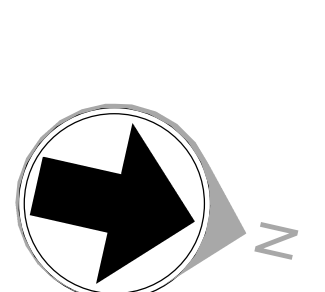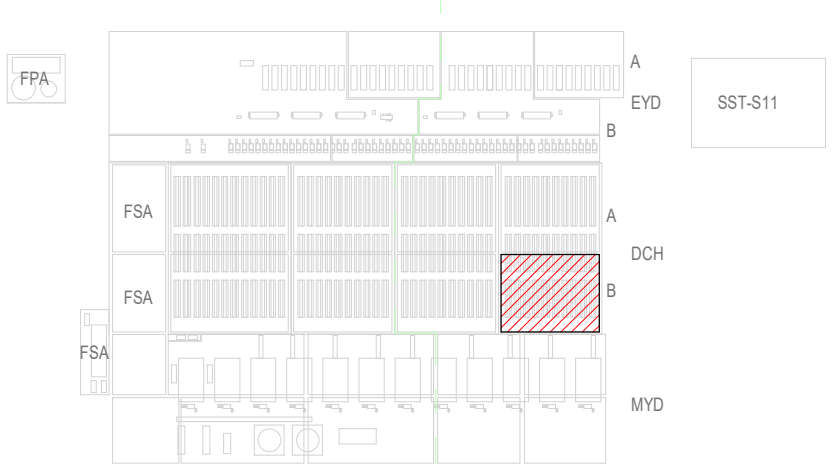

REVISIONS		
NO.	DATE	DESCRIPTION
0.1	06/06/2024	R00 DRAFT ISSUE
0.2	06/06/2024	R00 FINAL ISSUE
0.3	20/12/2024	IFC DRAFT ISSUE
0.4	21/02/2025	IFC DRAFT ISSUE
1.0	12/03/2025	IFC FINAL ISSUE
1.1	30/05/2025	POST IFC DRAFT ISSUE
2.0	20/06/2025	POST IFC FINAL ISSUE

Drawn By:
DS
Approved By:
GC
Design Team:
B&W

GDC - DCH-STR
BUCKINGHAM
Project Number: P20251

Foundation General Arrangement Shell 2 Sheet
4 of 4
Discipline:
STRUCTURAL
Scale: 1 : 100 Sheet Size: A0

Sheet Number:
STB1A-1.0-S-2009B-DCH
Current Rev: 2.0
Phase: IFC
Model Name: STB1A-DCH-STR.rvt
Native File Format: Revit v. 2025.4