


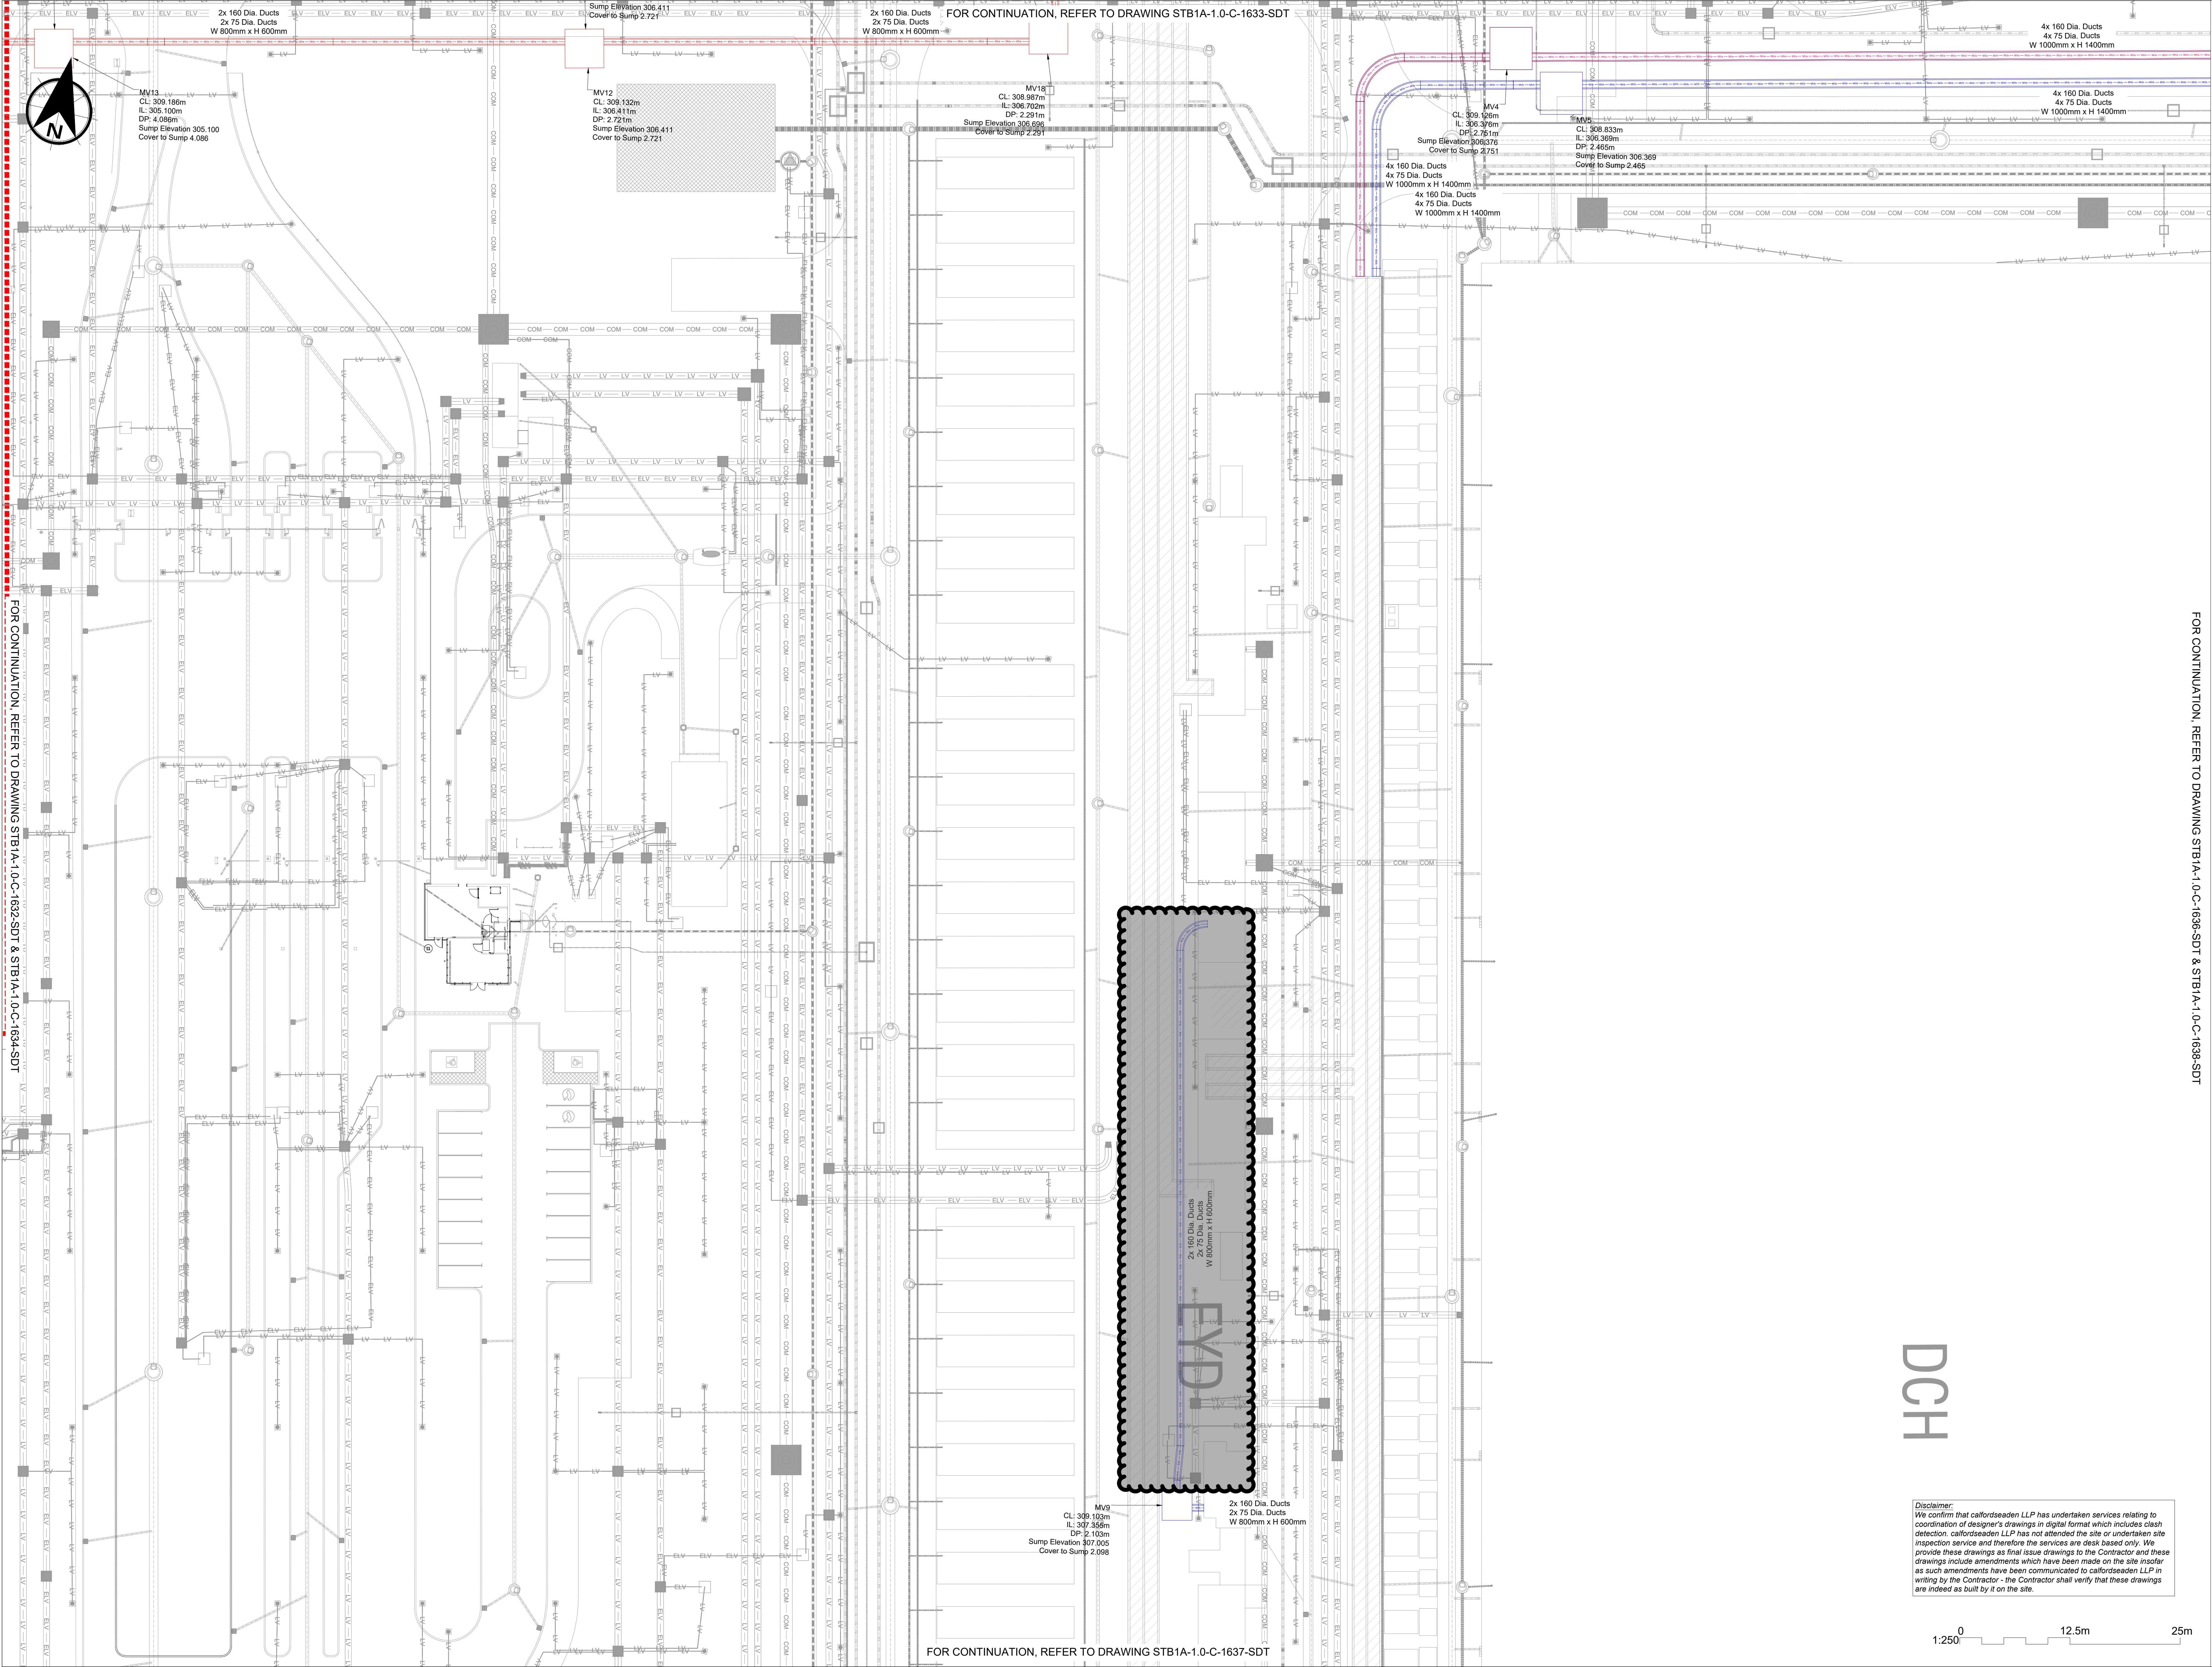

- NOTES:**
- ALL LEVELS ARE IN METRES ABOVE DATUM UNLESS STATED OTHERWISE.
 - DO NOT SCALE FROM THIS DRAWING. ALL DIMENSIONS INDICATED ARE IN METRES UNLESS OTHERWISE STATED. VALIDATE ALL MEASUREMENTS ON SITE.
 - ANY DISCREPANCIES BETWEEN THE DRAWINGS AND OTHER DOCUMENTS SHOULD BE BROUGHT TO THE ATTENTION OF THE ENGINEER.
 - THIS DRAWING IS NOT AN INSTALLATION DRAWING. IT IS THE CONTRACTORS RESPONSIBILITY TO MAKE FINAL COORDINATED INSTALLATION SHOP DRAWINGS.
 - THE CONTENTS OF THIS DRAWING SHALL BE READ IN CONJUNCTION WITH THE CURRENT REVISIONS OF ARCHITECTURAL, CIVIL, STRUCTURAL, MECHANICAL, ELECTRICAL SECURITY, TELECOMS DRAWINGS AND ALL RELEVANT SECTIONS OF THE SPECIFICATIONS.

- ADDITIONAL NOTES:**
- FOR REFERENCE OF TYPICAL DETAILS, PLEASE SEE SHEET STB1A-1.0-C-8630-SDT TO STB1A-1.0-C-8632-SDT.
 - CABLE PULLING EXERCISE TO BE CONDUCTED BY SPC. CHAMBER SIZES ARE AS ELECTRICAL ENGINEER DESIGN.
 - FOR HIGH VOLTAGE DUCT SIZES REFER TO DETAIL STB1A-1.0-C-8632-SDT.
 - ALL MV AND HV DUCTS TO BE HIGH-DENSITY POLYETHYLENE (HDPE) DUCT MATERIAL.
 - FINAL CABLE PULLING EXERCISE TO BE CARRIED OUT BY PMC.

- LEGEND**
- STB1A WORKING AREA BOUNDARY
 - TELECOMMUNICATION
 - EXTRA LOW VOLTAGE NETWORK
 - LOW VOLTAGE NETWORK
 - MEDIUM VOLTAGE ROUTE A
 - MEDIUM VOLTAGE ROUTE B
 - MEDIUM VOLTAGE HUB
 - HIGH VOLTAGE 110KV
 - SURFACE WATER DRAINAGE
 - SURFACE WATER CONTAMINATED
 - SURFACE WATER DRAINAGE CHANNEL
 - FOUL WATER DRAINAGE
 - INDUSTRIAL DRAINAGE
 - POTABLE WATER SUPPLY
 - RAW WATER INFLOW (COOLING)
 - HYDRANT MAIN
 - SPRINKLER MAIN
 - DISTRICT HEATING MAIN
 - BLOWDOWN WASTE
 - EXTRA LOW VOLTAGE CHAMBER
 - LOW VOLTAGE CHAMBER
 - MEDIUM VOLTAGE ROUTE A CHAMBER
 - MEDIUM VOLTAGE ROUTE B CHAMBER
 - MEDIUM VOLTAGE CHAMBER
 - HIGH VOLTAGE CHAMBER
 - TELECOMMUNICATION CHAMBER
 - FOUL WATER DRAINAGE PUMPING STATION
 - SURFACE WATER CHAMBER
 - SURFACE WATER CONTAMINATED CHAMBER
 - FOUL WATER CHAMBER
 - RAW WATER INFLOW (COOLING) CHAMBER
 - BLOWDOWN WASTE CHAMBER
 - FUEL INTERCEPTOR
 - FIRE RETENTION TANK
 - GULLY



FOR CONTINUATION, REFER TO DRAWING STB1A-1.0-C-1636-SDT & STB1A-1.0-C-1638-SDT

ARCHITECTURE:
ARC:MC
140-142 St. John Street,
London, EC1V 4UB
United Kingdom
t: +44 (0) 203 411 2571
e: info@arcmc.co.uk

INFRASTRUCTURE / CIVILS:
SWECO
Eldon House
2-3 Eldon Street
London
EC2M 7LS
t: +44 (0) 20 3002 1210
e: www.sweco.co.uk

MEP:
Black & White Engineering
69 Wilson Street,
London, EC2A 2BB
United Kingdom
t: +44 (0) 207 683 7166
e: londoneng@bw-engineering.com

STB1A - PUF - IFC
ISSUED FOR CONSTRUCTION
16/02/2026

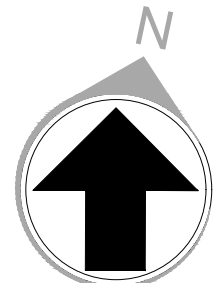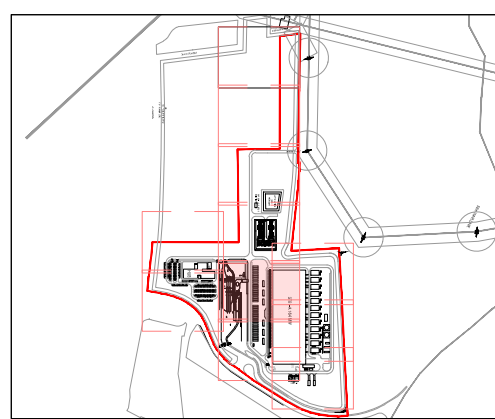

REVISIONS			Drawn By:
NO.	DATE	DESCRIPTION	MRP
0.1	16/01/2025	DRAFT IFC ISSUE	Approved By:
0.2	21/02/2025	DRAFT IFC UPDATES	CM
0.3	12/03/2025	DRAFT IFC UPDATES	Design Team:
1.0	11/04/2025	IFC FINAL ISSUE	BW
1.1	05/08/2025	POST IFC DRAFT ISSUE	
2.0	09/03/2026	IFC ISSUE - CONSTRUCTION	
3.0	16/02/2026	IFC ISSUE - CONSTRUCTION	

STB1A

BUCKINGHAM

Project Number: 65212899

**Proposed Site Medium and High Voltage
Services Layout Sheet 5**

Discipline: Civil

Scale: 1:250

Sheet Size: A0

Sheet Number:
STB1A-1.0-C-1635-SDT

Current Rev: 3.0
Phase: IFC

Drawing Name: STB1A-1.0-C-1635-SDT.dwg

Native File Format: Civil 3D V.2024