


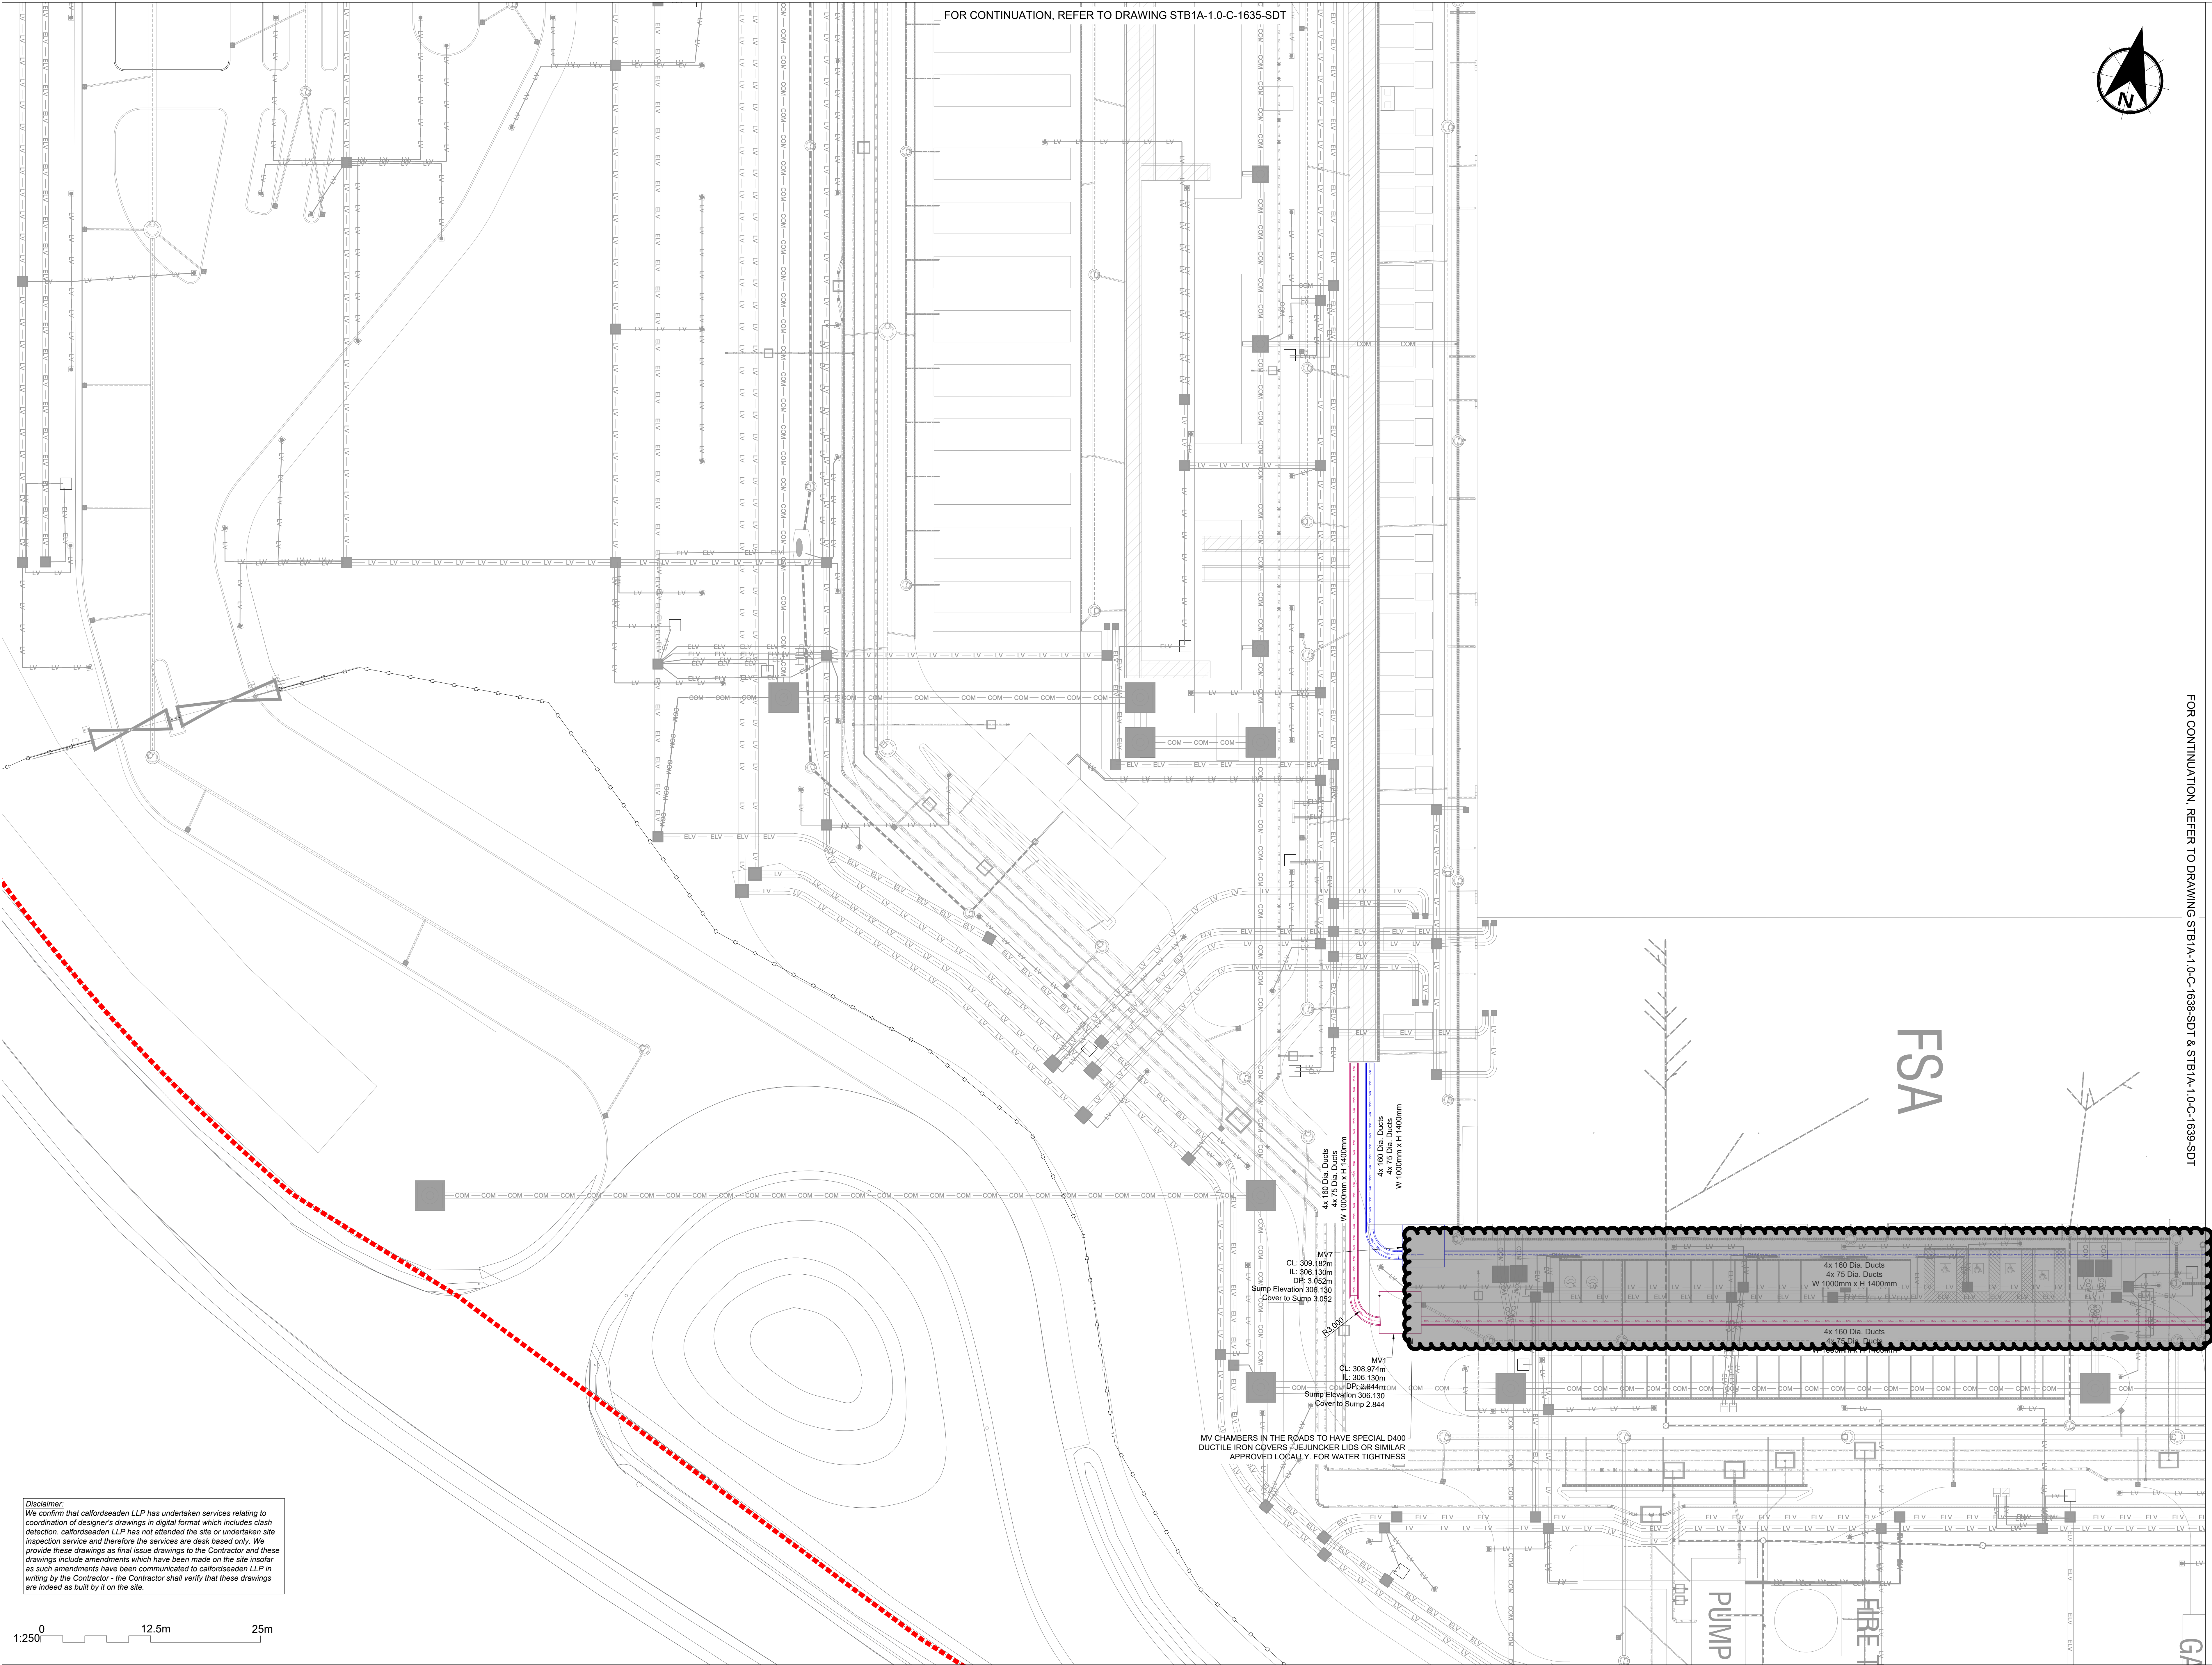

- NOTES:
1. ALL LEVELS ARE IN METRES ABOVE DATUM UNLESS STATED OTHERWISE.
 2. DO NOT SCALE FROM THIS DRAWING. ALL DIMENSIONS INDICATED ARE IN METRES UNLESS OTHERWISE STATED. VALIDATE ALL MEASUREMENTS ON SITE.
 3. ANY DISCREPANCIES BETWEEN THE DRAWINGS AND OTHER DOCUMENTS SHOULD BE BROUGHT TO THE ATTENTION OF THE ENGINEER.
 4. THIS DRAWING IS NOT AN INSTALLATION DRAWING. IT IS THE CONTRACTORS RESPONSIBILITY TO MAKE FINAL COORDINATED INSTALLATION SHOP DRAWINGS.
 5. THE CONTENTS OF THIS DRAWING SHALL BE READ IN CONJUNCTION WITH THE CURRENT REVISIONS OF ARCHITECTURAL, CIVIL, STRUCTURAL, MECHANICAL, ELECTRICAL SECURITY, TELECOMS DRAWINGS AND ALL RELEVANT SECTIONS OF THE SPECIFICATIONS.

- ADDITIONAL NOTES:
1. FOR REFERENCE OF TYPICAL DETAILS, PLEASE SEE SHEET STB1A-1.0-C-8630-SDT to STB1A-1.0-C-8632-SDT.
 2. CABLE PULLING EXERCISE TO BE CONDUCTED BY SPC. CHAMBER SIZES ARE AS ELECTRICAL ENGINEER DESIGN.
 3. FOR HIGH VOLTAGE DUCT SIZES REFER TO DETAIL, STB1A-1.0-C-8632-SDT.
 4. ALL MV AND HV DUCTS TO BE HIGH-DENSITY POLYETHYLENE (HDPE) DUCT MATERIAL.
 5. FINAL CABLE PULLING EXERCISE TO BE CARRIED OUT BY PMC



- LEGEND
- STB1A WORKING AREA BOUNDARY
 - TELECOMMUNICATION
 - EXTRA LOW VOLTAGE NETWORK
 - LOW VOLTAGE NETWORK
 - MEDIUM VOLTAGE ROUTE A
 - MEDIUM VOLTAGE ROUTE B
 - MEDIUM VOLTAGE HUB
 - HIGH VOLTAGE 110kV
 - SURFACE WATER DRAINAGE
 - SURFACE WATER CONTAMINATED
 - SURFACE WATER DRAINAGE CHANNEL
 - FOUL WATER DRAINAGE
 - INDUSTRIAL DRAINAGE
 - POTABLE WATER SUPPLY
 - RAW WATER INFLOW (COOLING)
 - HYDRANT MAIN
 - SPRINKLER MAIN
 - DISTRICT HEATING MAIN
 - BLOWDOWN WASTE
 - EXTRA LOW VOLTAGE CHAMBER
 - LOW VOLTAGE CHAMBER
 - MEDIUM VOLTAGE ROUTE A CHAMBER
 - MEDIUM VOLTAGE ROUTE B CHAMBER
 - MEDIUM VOLTAGE CHAMBER
 - HIGH VOLTAGE CHAMBER
 - TELECOMMUNICATION CHAMBER
 - FOUL WATER DRAINAGE PUMPING STATION
 - SURFACE WATER CHAMBER
 - SURFACE WATER CONTAMINATED CHAMBER
 - FOUL WATER CHAMBER
 - RAW WATER INFLOW (COOLING) CHAMBER
 - BLOWDOWN WASTE CHAMBER
 - FUEL INTERCEPTOR
 - FIRE RETENTION TANK
 - GULLY

ARCHITECTURE:
ARC:MC
140-142 St. John Street,
London, EC1V 4UB
United Kingdom
t: +44 (0) 203 411 2571
e: info@arcmc.co.uk

INFRASTRUCTURE / CIVILS:
SWECO
Eldon House
2-3 Eldon Street
London,
EC2M 7LS
t: +44 (0) 20 3002 1210
e: www.sweco.co.uk

MEP:
Black & White Engineering
69 Wilson Street,
London, EC2A 2BB
United Kingdom
t: +44 (0) 207 683 7166
e: londoneng@bw-engineering.com

STB1A - PUF - IFC
ISSUED FOR CONSTRUCTION
16/02/2026

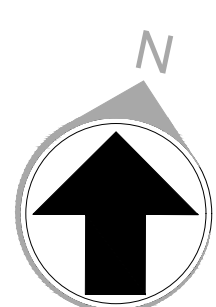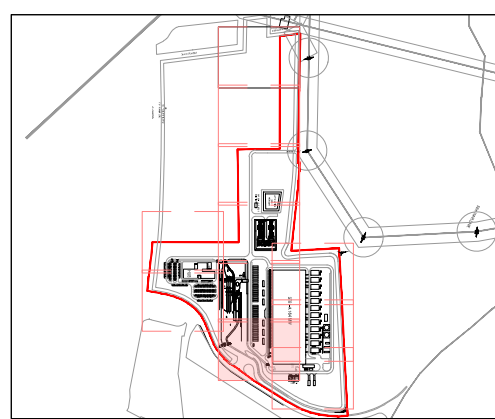

REVISIONS		
NO.	DATE	DESCRIPTION
0.1	16/01/2025	DRAFT IFC ISSUE
0.2	21/02/2025	DRAFT IFC UPDATES
0.3	12/03/2025	DRAFT IFC UPDATES
1.0	11/04/2025	IFC FINAL ISSUE
2.0	09/02/2026	IFC ISSUE - CONSTRUCTION
3.0	16/02/2026	IFC ISSUE - CONSTRUCTION

Drawn By:
MP
Approved By:
PD
Design Team:
BW

STB1A
BUCKINGHAM

Project Number: 65212899

Proposed Site Medium and High Voltage
Services Layout Sheet 7

Discipline: Civil
Scale: 1:250
Sheet Size: A0

Sheet Number:
STB1A-1.0-C-1637-SDT
Current Rev: 3.0
Phase: IFC
Drawing Name: STB1A-1.0-C-1637-SDT.dwg
Native File Format: Civil 3D V.2024

